Engineering Change Notice (**ECN**)

Job info

Date: Tue Oct 27 2026
Number: 26-021
Name: Retreat & Co
Contact:
Phone:
E-mail:
Project: Caldwell Residence
Address:
City: deanville
State: Texas
Zip:

Sheet No.	Drawing No.	Reason	Description(s)	Revision
A2-01	**1**	ADJUSTMENT	REDISIGNED VSB TO ACCOMMODATE PLUMBING	**LEVEL 1**
A2-01	**1**	MARKUP	DRAWER SECTIONS ADJUSTED TO 16" WIDE ADDED GROOMING DRAWER	**LEVEL 1**
A2-01	**1**	MARKUP	ADDED UPPER @ CENTER ON TOP OF COUNTER	**LEVEL 1**
A2-01	**2**	MARKUP	ADJUSTED BASE CABINET FINISHED HEIGHT TO 46" W/3" TOP DRAWER & 2 EQ BELOW; REMOVED TOE KICK AND WIDENED BOTTOM RAIL	**LEVEL 1**
A2-01	**2**	MARKUP	ADDED UPPER WITH GLASS DOORS	**LEVEL 1**
A2-01	**3**	MARKUP	ADJUSTED CABINET HEIGHT TO GO TO CEILING	**LEVEL 1**
A2-01	**4**	ADJUSTMENT	SHIFTED CABINE TO RIGHT TO AVOID METAL BOX IN WALL	**LEVEL 1**
A2-01	**6**	MARKUP	ADDED 2 DRAWER BENCHES	**LEVEL 1**
A2-01	**7**	MARKUP	SWAPPED BEV COOLER LOCATION WITH B23 FF; CHANGED B23 FF TO 4 DRAWER BASE AND MODIFIED LIQUOR DRAWER; ADJUSTED UPPERS TO CEILING WITH GLASS DOORS AND OPEN SHELVES IN THE CENTER	**LEVEL 1**
A2-01	**8**	MARKUP	ADDED REEDED TOP PANEL	**LEVEL 1**
A2-02	**1**	MARKUP	ADDED UPPER OVER REFRIGERATOR W/DIVISION @ CENTER ADDING ADJUSTABLE SHELVES TO THE LEFT SIDE AND A PULL OUT ON THE RIGHT SIDE WITH DIVIDER	**LEVEL 1**
A2-02	**1**	MARKUP	LEFT A SPACE FOR TYP. DISWASHER SPECS AS OPPOSED TO A RAISED DISHWASHER SHOWN ON ARCHITECTS PLAN	**LEVEL 1**
A2-02	**1**	ADJUSTMENT	SINK SHIFTED TO THE RIGHT MORE TO ALIGN WITH PLUMBING AND AVOID GAS SHUT OFF VALVE FOR KITCHEN RANGE	**LEVEL 1**
A2-02	**3**	MARKUP	ADDED A PANTRY WITH DIVIDERS IN 2 LOWER BAYS; ADJUSTED OVEN CABINET TO CONFIRMED APPPLIANCE SPECS	**LEVEL 1**
A2-02	**4**	MARKUP	REMOVED UPPER OVER WASHER/DRYER	**LEVEL 1**
A2-02	**4**	MARKUP	ADDED CUSTOM PULLOUT DRAWERS BELOW SINK	**LEVEL 1**
A2-02	**4**	MARKUP	MOVED DRYING RACK CABINET TO THIS SIDE OF THE ROOM	**LEVEL 1**
A2-02	**4**	MARKUP	MOVED BROOM CLOSET TO THIS SIDE OF THE ROOM	**LEVEL 1**
A2-02	**4**	MARKUP	DELETED DROP ZONE CABINETS AND ADDED HOBBY ALCOVE DESK	**LEVEL 1**
A2-03	**1**	MARKUP	REVISED REFRIGERATOR CABINET AFTER RECEIVING CONFIRMED APPLIANCE SPECS	**LEVEL 1**
A2-03	**1**	ADJUSTMENT	ADJUSTED BASE CABINET LEFT OF REFRIGERATOR CABINET AND ADDED DECORATIVE BOTTOM FF RAIL	**LEVEL 1**
A2-03	**1**	ADJ. / MARKUP	ADJUSTED UPPER SIZE FOR REFRIGERATOR CABINET AND MADE ALL DOORS WITH GLASS PANELS	**LEVEL 1**
A2-03	**2**	MARKUP	REVISED BASE CABINETS TO HAVE DBL TOP DRAWERS/SINGLES BELOW; DECORATIVE BOTTOM FF RAIL	**LEVEL 1**

A2-03	**2**	MARKUP	UPPER CABINETS NOW HAVE GLASS DOORS ON UPPER BAYS	**LEVEL 1**
A2-03	**2**	MARKUP	SIDE SWOOPS REMOVED ON VENT HOOD; ENGRAVING ADDED	**LEVEL 1**
A2-03	**3**	MARKUP	SINK BASE REVISED TO FARM SINK (DIMS. TBD)	**LEVEL 1**
A2-03	**3**	MARKUP	TRASH DRAWER ADDED TO LEFT OF SINK WITH 3 DRAWERS ADDED TO LEFT OF TRASH DRAWER	**LEVEL 1**
A2-03	**3**	MARKUP	DISHWASHER DRAWERS CHANGED TO SELECTED DISHWASHER SPECS	**LEVEL 1**
A2-03	**3,4,5**	MARKUP	TURNED POSTS ADDED TO ISLAND CORNERS	**LEVEL 1**
A2-03	**5**	ADJUSTMENT	COUNTERTOP SUPPORT ADDED TO ISLAND SEATING OVERHANG	**LEVEL 1**
A2-04	**3**	MARKUP	UPPER OVER TOILET EXTENDED HEIGHT TO CEILING (VERIFY VENT CLEARANCE IN FIELD)	**LEVEL 1**
A2-04	**EXPIRED**	MARKUP	REMOVE BDR 2 DRESSER LINEN	**LEVEL 1**
A2-04	**EXPIRED**	MARKUP	REMOVE LIVING RM CABINETS	**LEVEL 1**
A2-04	**6**	ADDED	BATH 4 VANITY SINK BASE ADDED	
		ADDED	NEED MORE INFO ON "Addinglower in hall across from stairs/ (illegible) w/sink across niche…"	
		ADDED	NEED MORE INFO ON BONUS ROOM	

CABINET SCHEDULE

	LOCATION	CABINET STYLE	DOOR STYLE	FINISH	DRAWER GUIDES	HINGES	COUNTERTOPS
101	MASTER BATH	INSET FF	TBD	WHITE OAK UNO	TANDEM SOFT CLOSE	EURO SOFT CLOSE	B/O 2CM UNO
102	MASTER CLOSET	OVERLAY FACE FRAME	TBD	PG	TANDEM SOFT CLOSE	EURO SOFT CLOSE	B/O 2CM UNO
103	COFFEE BAR	INSET FF	TBD	PG	TANDEM SOFT CLOSE	EURO SOFT CLOSE	B/O 2CM UNO
104	½ BATH	OVERLAY FACE FRAME	TBD	PG	TANDEM SOFT CLOSE	EURO SOFT CLOSE	B/O 2CM UNO
105	SCULLERY	OVERLAY FACE FRAME	TBD	PG	TANDEM SOFT CLOSE	EURO SOFT CLOSE	B/O 2CM UNO
106	UTILITY	OVERLAY FACE FRAME	TBD	PG	TANDEM SOFT CLOSE	EURO SOFT CLOSE	B/O 2CM UNO
107	HOBBY ALCOVE	OVERLAY FACE FRAME	TBD	PG	TANDEM SOFT CLOSE	EURO SOFT CLOSE	B/O 2CM UNO
108	KITCHEN	INSET FF	TBD	PG	TANDEM SOFT CLOSE	EURO SOFT CLOSE	B/O 2CM UNO
	KITCHEN ISLAND	INSET FF	TBD	WHITE OAK UNO	TANDEM SOFT CLOSE	EURO SOFT CLOSE	B/O 2CM UNO
	KITCHEN VENT HOOD	INSET FF	TBD	WHITE OAK UNO	TANDEM SOFT CLOSE	EURO SOFT CLOSE	B/O 2CM UNO
109	LIBRARY	INSET FF	TBD	PG	TANDEM SOFT CLOSE	EURO SOFT CLOSE	B/O 2CM UNO
110	BATH 2	OVERLAY FACE FRAME	TBD	PG	TANDEM SOFT CLOSE	EURO SOFT CLOSE	B/O 2CM UNO
111	BATH 3	OVERLAY FACE FRAME	TBD	PG	TANDEM SOFT CLOSE	EURO SOFT CLOSE	B/O 2CM UNO
112	BDR 3 CLOSET	OVERLAY FACE FRAME	TBD	PG	TANDEM SOFT CLOSE	EURO SOFT CLOSE	B/O 2CM UNO
201	BATH 4	OVERLAY FACE FRAME	TBD	PG	TANDEM SOFT CLOSE	EURO SOFT CLOSE	B/O 2CM UNO
202	LOFT	OVERLAY FACE FRAME	TBD	PG	TANDEM SOFT CLOSE	EURO SOFT CLOSE	B/O 2CM UNO

APPLIANCE SCHEDULE

	LOCATION	MODEL #	DESCRIPTION	PANEL SIZE
103	COFFEE BAR	PRB24C01CG	UC REFRIGERATOR	
105	SCULLERY	N/A	REFRIGERATOR	
		CDT858P2VS1	DISHWASHER	
		CSB912P2NS1	27" WALL OVEN	
		CTS70DP2ZS1	30" WALL OVEN	
108	KITCHEN	INPL4819SSNB-B	48" HOOD LINER	
		PRDA1922AF	REFRIGERATOR	
		PRDA1922AF	REFRIGERATOR	
		CDT858P2VS1	DISHWASHER	
	N/A	KUIX515SPS	ICE MAKER	

ARCHITECT
N/A

GENERAL CONTRACTOR
N/A

FABRICATION / INSTALLATION
Grant Designs,LLC
6631 Raymond Stotzer Pkwy
College Station, Tx. 77845

TAMU

Project Title: 26-024 Caldwell Residence
Project Number:
Project Address:
Project Phone:
Project E-Mail:
Contractor:
Project Fax:
Sheet Title:

REVISIONS:

No.	Date:	By:	Description:
1			
2			
3			
4			
5			
6			
7			
8			

Scale	9/128" = 1'
Date Issued	10.27.2026
Sheet Number	COVER

PORCH
10' CLG
9' x 8' WINDOW/DOOR UNIT
3068
SLOPE CLG
STORAGE
(POOL SUPPLIES)
W/ VENTILATION
6" WALL
W.I.C.
(HERS)
10' CLG
W.I.C.
(HIS)
10' CLG
DRESSER
LINEN
DRESSER
CATHEDRAL CEILING
M. BEDROOM
LEDGE W/
SHELF
*2-1680
ANTIQUE DRS.
4040 FIXED
@ 8'-0"
FREE-STANDING
TUB
10' CLG
M.BATH
CATHEDRAL CEILING
LEDGE
HB
LEDGE W/
SHELF
ZERO TRESHOLD
SHOWER
10' CLG
6" WALL
DOG AREA
2016 FIXED
@ 8'-8"
10' CLG
SIDE
PORCH
3080
1/2 GL.
3080
DUTCH
DOOR
3080
W/ WEATHER STRIPPING
3080
UP
3' UP
SLOPE FLOOR
HOBBY GARAGE
10' CLG
9' x 8' O.H. GARAGE DOOR
FUTURE ICE
MACHINE
FLOOR DRAIN
REF
7' x 8' S.R.
SINK
6" WALL
HB
3080
METAL DOOR
W/ LOCK
3080
GUN
SAFE
HUNTING
STORAGE
10' CLG
DROP
ZONE
10' CLG
BC
SINK
UTIL
10' CLG
W
D
6" WALL
DRY-AWAY
PULL-OUT
RACKS
VENT
2-CAR GARAGE
10' CLG
SHEETROCK WALLS & CEILING THROUGHOUT.
FIREPROOFING PER CODE.
SLOPE FLOOR
18' x 8' O.H. GARAGE DOOR
6" WALL
2040 CASEMENT
@ 8'-0"
2040 CASEMENT
@ 8'-0"
2860 CASEMENT
@ 8'-0"
2040 CASEMENT
@ 8'-0"
HB
2860 CASEMENT
@ 8'-0"
SHED
ROOF
2040 CASEMENT
@ 8'-0"
HB
2860 CASEMENT
@ 8'-0"
SHED
ROOF
SCULLERY
KITCHEN
10' CLG
PAN
OVEN
REF
RAISED
DW
SINK
*2880
*3080
6" WALL
KITCHEN
12' CLG
R & O
SINK
POT
FILLER
ISLAND
DW
DRAWER
CAB'T ON
BACK SIDE
OF ISLAND
3' x 8' C.O.
W/ DECORATIVE
WOOD HEADER
3' x 8' C.O.
W/ DECORATIVE
WOOD HEADER
10' CLG
*3080
3080
3080
REF
MEDIA
CLOSET
(W/ VENTILATION)
2480
OPT. LOUV DR
HOBBY
ALCOVE
10' CLG
EXERCISE
10' CLG
TREADMILL
STATIONARY
BIKE
LIBRARY
10' CLG
*2-2680
11' CLG
BRICK
7' x 9' C.O.
FOYER
12' STEP-UP CLG
WOOD AT
STEP-UP CLG
11' CLG
2-2680
FR.DOORS
2-3080
W/ 6014 TRANS
2-2680
FR.DOORS
BEDROOM 2
10' CLG
DRESSER/LINEN
3'-6" x 8' S.R.
3080
POCKET
B-2
10' CLG
42" HGT.
WALL
6" WALL
LINEN
SHELVES
2880
3080
POCKET
B-3
10' CLG
SHOWER
6" WALL
LINEN
R & S
10' CLG
6" WALL
2040 @ 8'-0"
CASEMENT
AC
BEDROOM 3
10' CLG
3080
POCKET
2880
EGRESS/INGRESS
2860 CASEMENT
@ 8'-0"
STORAGE
10' CLG
HB
3' x 8' C.O.
6" WALL
FAMILY RM
CATHEDRAL CEILING
RASIED
BRICK HEARTH
F.P.
OPT. CAB'T
AND SHELVES
BRICK
OPT. CAB'T
AND SHELVES
6" WALL
DINING
12' STEP-UP CLG
BRICK
11' CLG
6" WALL
11' CLG
BRICK
NOOK
12' CLG
6" WALL
SMALL SINK
WALL MOUNT
1/2
BATH
10' CLG
3080
2880
W/ BLINDS
9' x 8' WINDOW/DOOR UNIT
5070 PICTURE
@ 8'-0" W/
5020 TRANS
@ 11'-0"
5070 PICTURE
@ 8'-0" W/
5020 TRANS
@ 11'-0"
5070 PICTURE
@ 8'-0" W/
5020 TRANS
@ 11'-0"
9' x 8' WINDOW/DOOR UNIT
GRILLING
PORCH
11' CLG
GRIDDLE
GRILL
SLOPE CLG
TRASH
SINK
BEVERAGE
COOLER
SCREENED
DOORS
OUTDOOR
DINING
11' CLG
SLOPE CLG
SCREENED
DOOR
MOTORIZED
RETRACTABLE
SCREEN
12" COLUMNS
WRAP WITH BRICK
MOTORIZED
RETRACTABLE
SCREEN
MOTORIZED
RETRACTABLE
SCREEN
MOTORIZED
RETRACTABLE
SCREEN
MOTORIZED
RETRACTABLE
SCREEN
12" COLUMNS
WRAP WITH BRICK
REAR
PORCH
12' CEILING
F.P.
COFFEE BAR
BEVERAGE
COOLER
3' x 8' C.O.
SHELVES
SINK
10' CLG
FRONT
PORCH
11' CLG
12" COLUMNS
116'-11"
73'-0"
81'-11"
33'-8"
25'-0"
27'-0"
23'-0"
14'-0"
13'-0"
10'-8"
9'-0"
7'-4"
6'-6"
5'-0"
4'-0"
2'-0"
1'-0"
0'-8"
5½"

FLOOR PLAN

Texas A&M University 1876

TAMU

Project Title: 26-024 Caldwell Residence

Project Number:

Project Address:

Project Phone: Project Fax:

Project E-Mail:

Contractor:

Sheet Title:


REVISIONS:

No.	Date:	By:	Description:
1			
2			
3			
4			
5			
6			
7			
8			

Scale: 1/4" = 1'

Date Issued: 10.27.2026

Sheet Number: PLAN

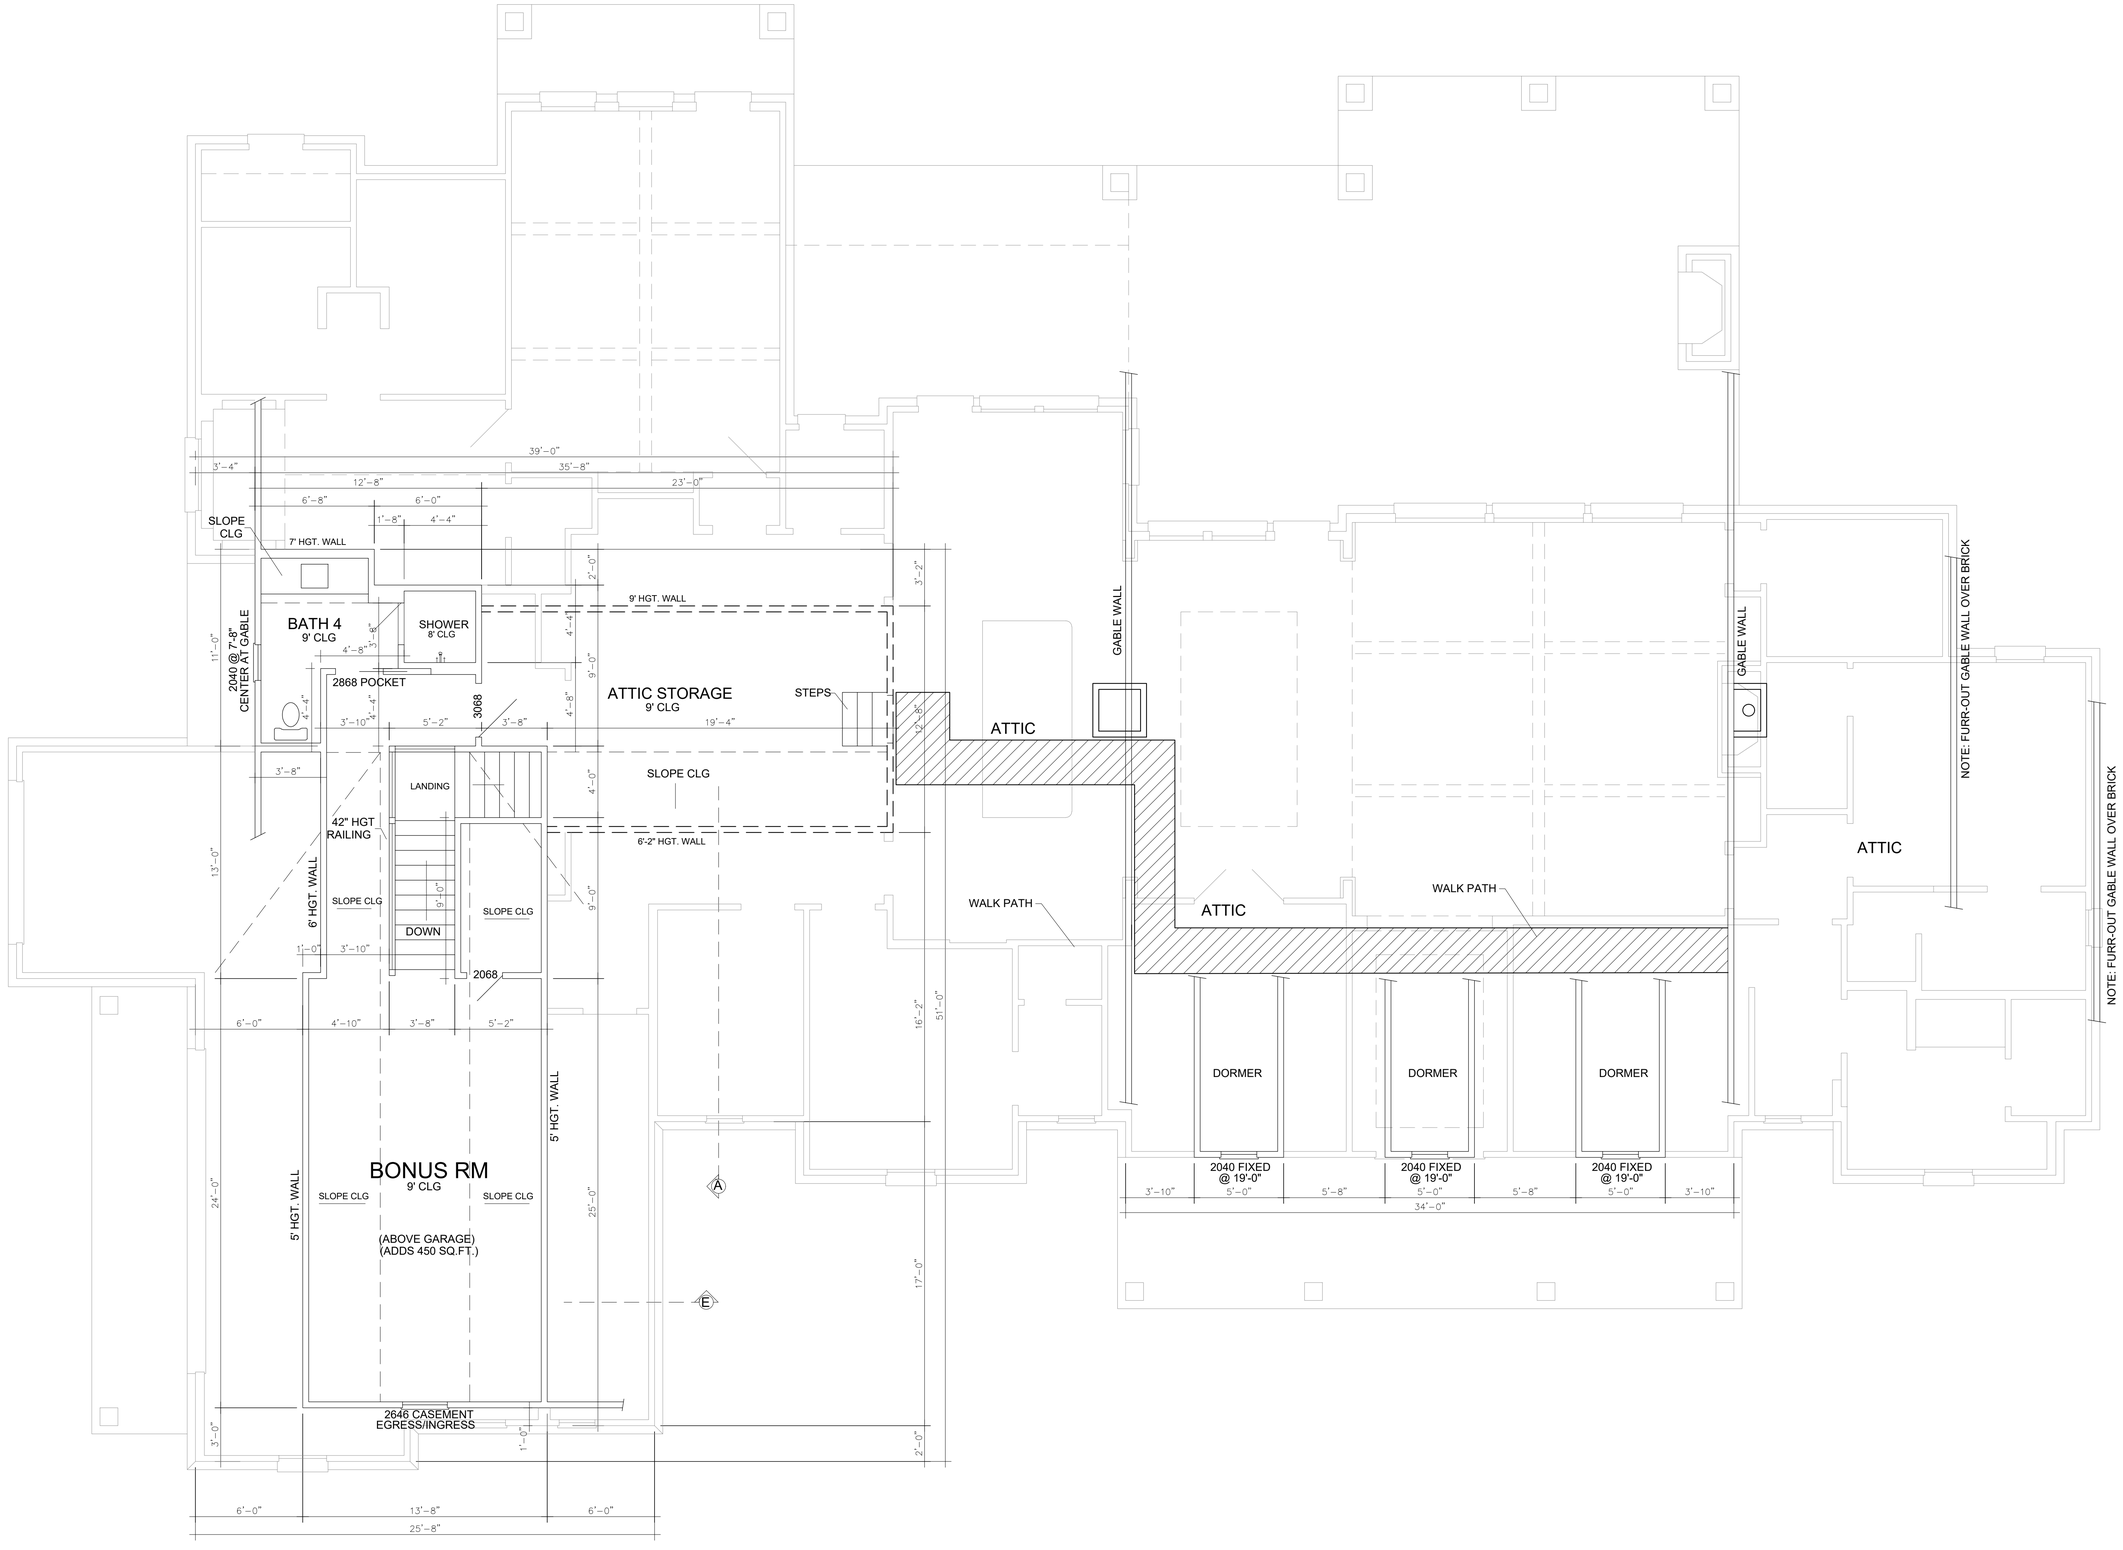

CUTTING EDGE CABINET DESIGN

TEXAS A&M UNIVERSITY 1876

TAMU

Project Title: 26-024 Caldwell Residence

Project Number:

Project Address:

Project Phone: Project Fax:

Project E-Mail:


Contractor:

Sheet Title:

REVISIONS:

No.	Date:	By:	Description:
1			
2			
3			
4			
5			
6			
7			
8			

Scale	1/4" = 1'
Date Issued	10.27.2026
Sheet Number	PLAN 2

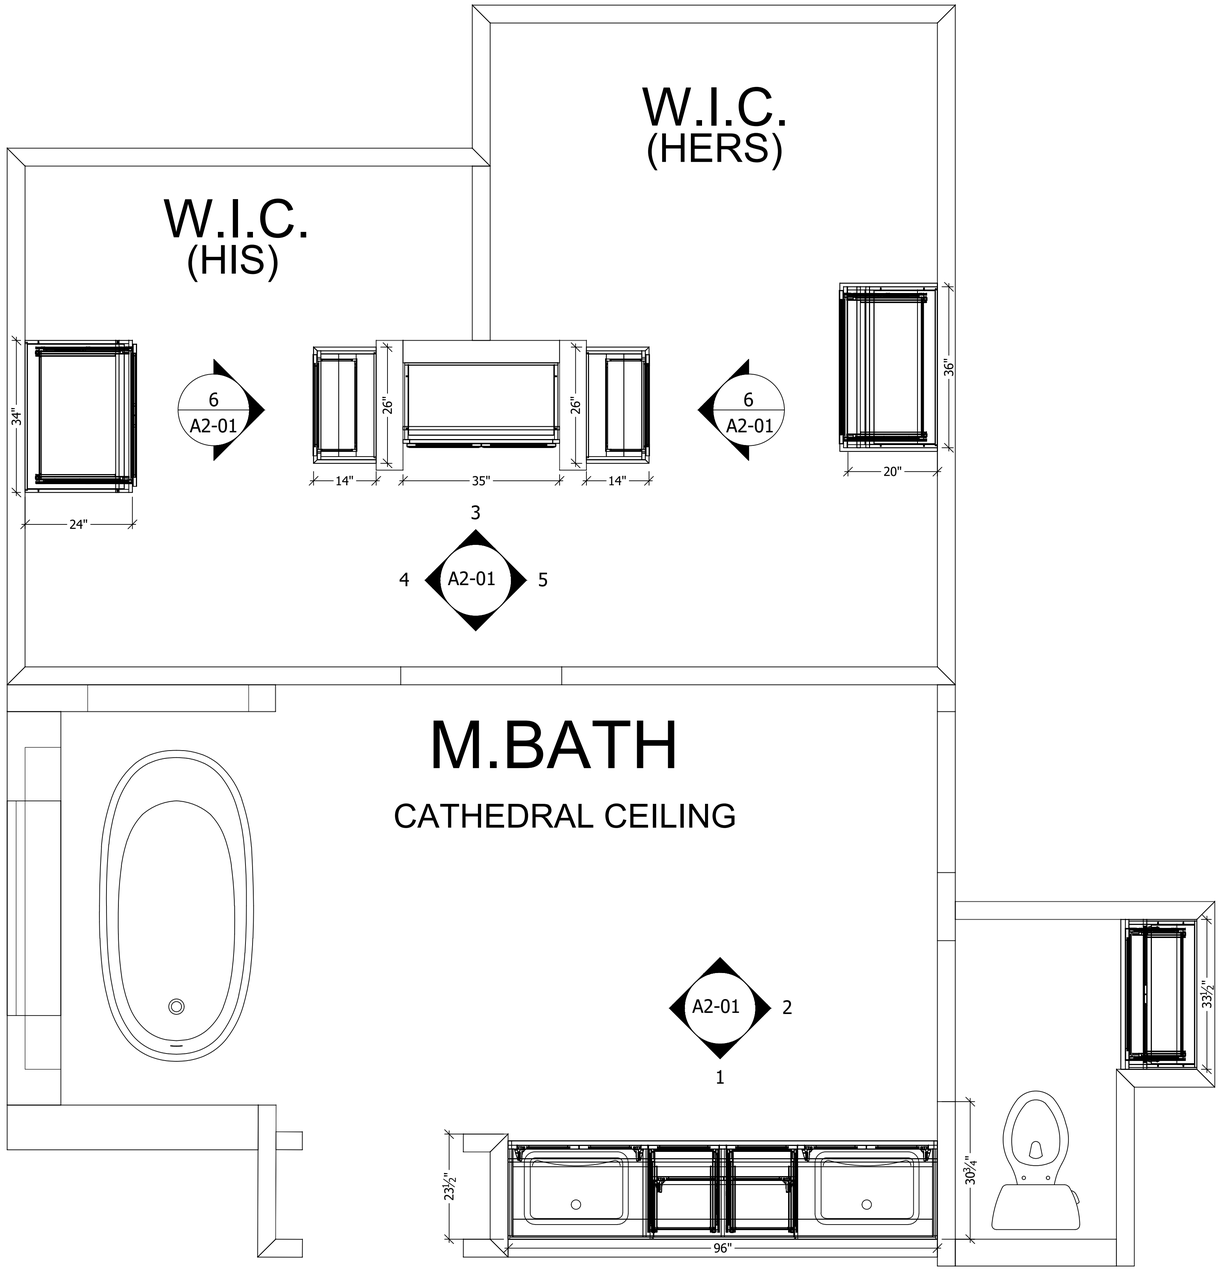

1 PLAN WIC 102 / M. BATH 101

Sheet Ref: PLAN


TAMU

Project Title: 26-024 Caldwell Residence
Project Number:
Project Address:
Project Phone:
Project Fax:
Project E-Mail:
Contractor:
Sheet Title:

REVISIONS:

No.	Date:	By:	Description:
1			
2			
3			
4			
5			
6			
7			
8			

Scale	3/4" = 1'
Date Issued	10.27.2026
Sheet Number	A1-01

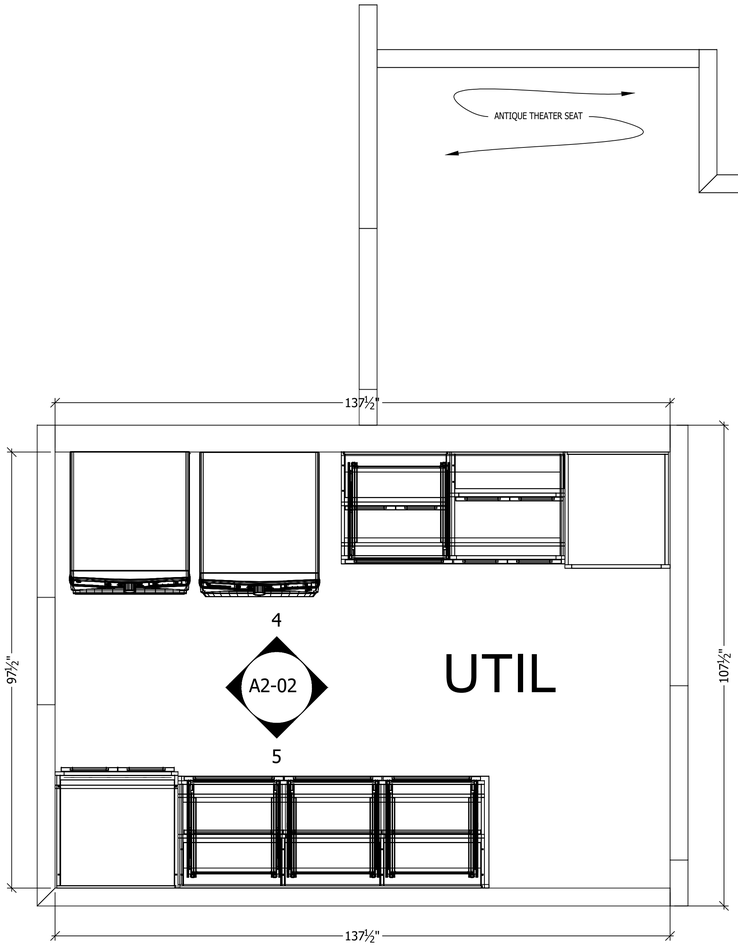


4

A2-02

5


UTIL

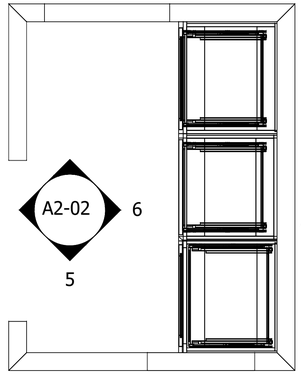

A2-02 6

5

HOBBY ALCOVE

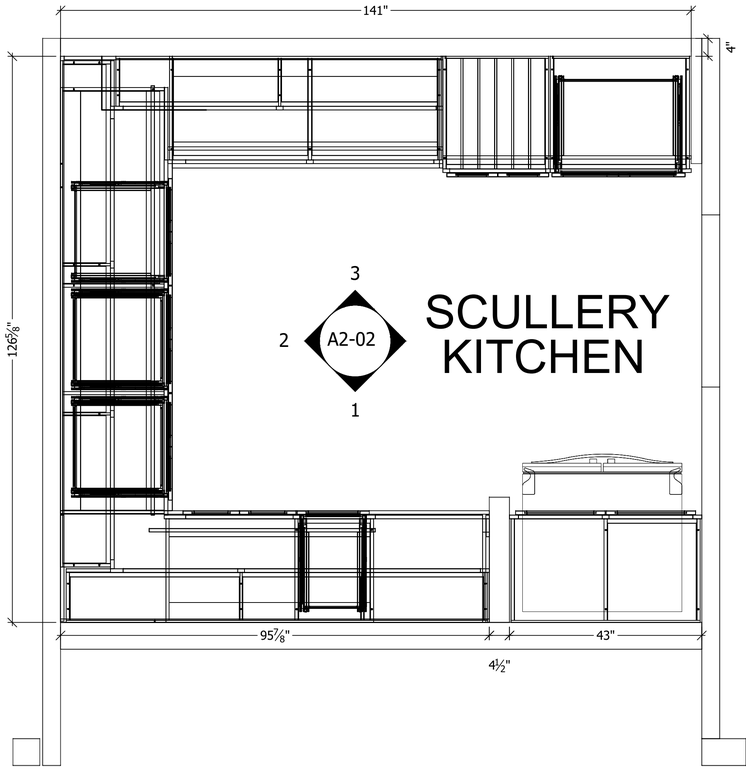

3

2 A2-02


1

SCULLERY KITCHEN

ANTIQUE THEATER SEAT

COFFEE BAR

A2-01 7

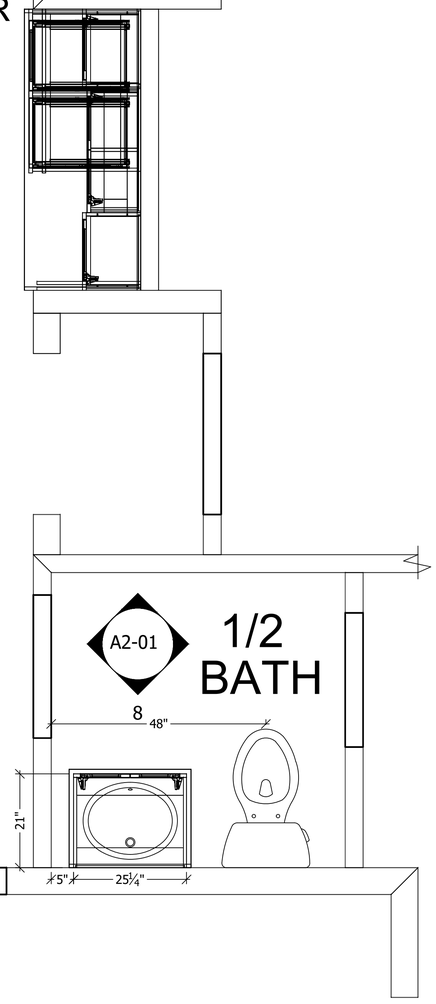

A2-01

1/2 BATH

2 PLAN UTILITY / HOBBY ALCOVE / COFFEE BAR / SCULLERY

SHEET REF: PLAN

CUTTING EDGE CABINET DESIGN

TEXAS A&M UNIVERSITY 1876

TAMU

Project Title: 26-024 Caldwell Residence

Project Number:

Project Address:

Project Phone:

Project Fax:

Project E-Mail:


Contractor:

Sheet Title:

REVISIONS:

No.	Date:	By:	Description:
1			
2			
3			
4			
5			
6			
7			
8			

Scale	3/4" = 1'
Date Issued	10.27.2026
Sheet Number	A1-02

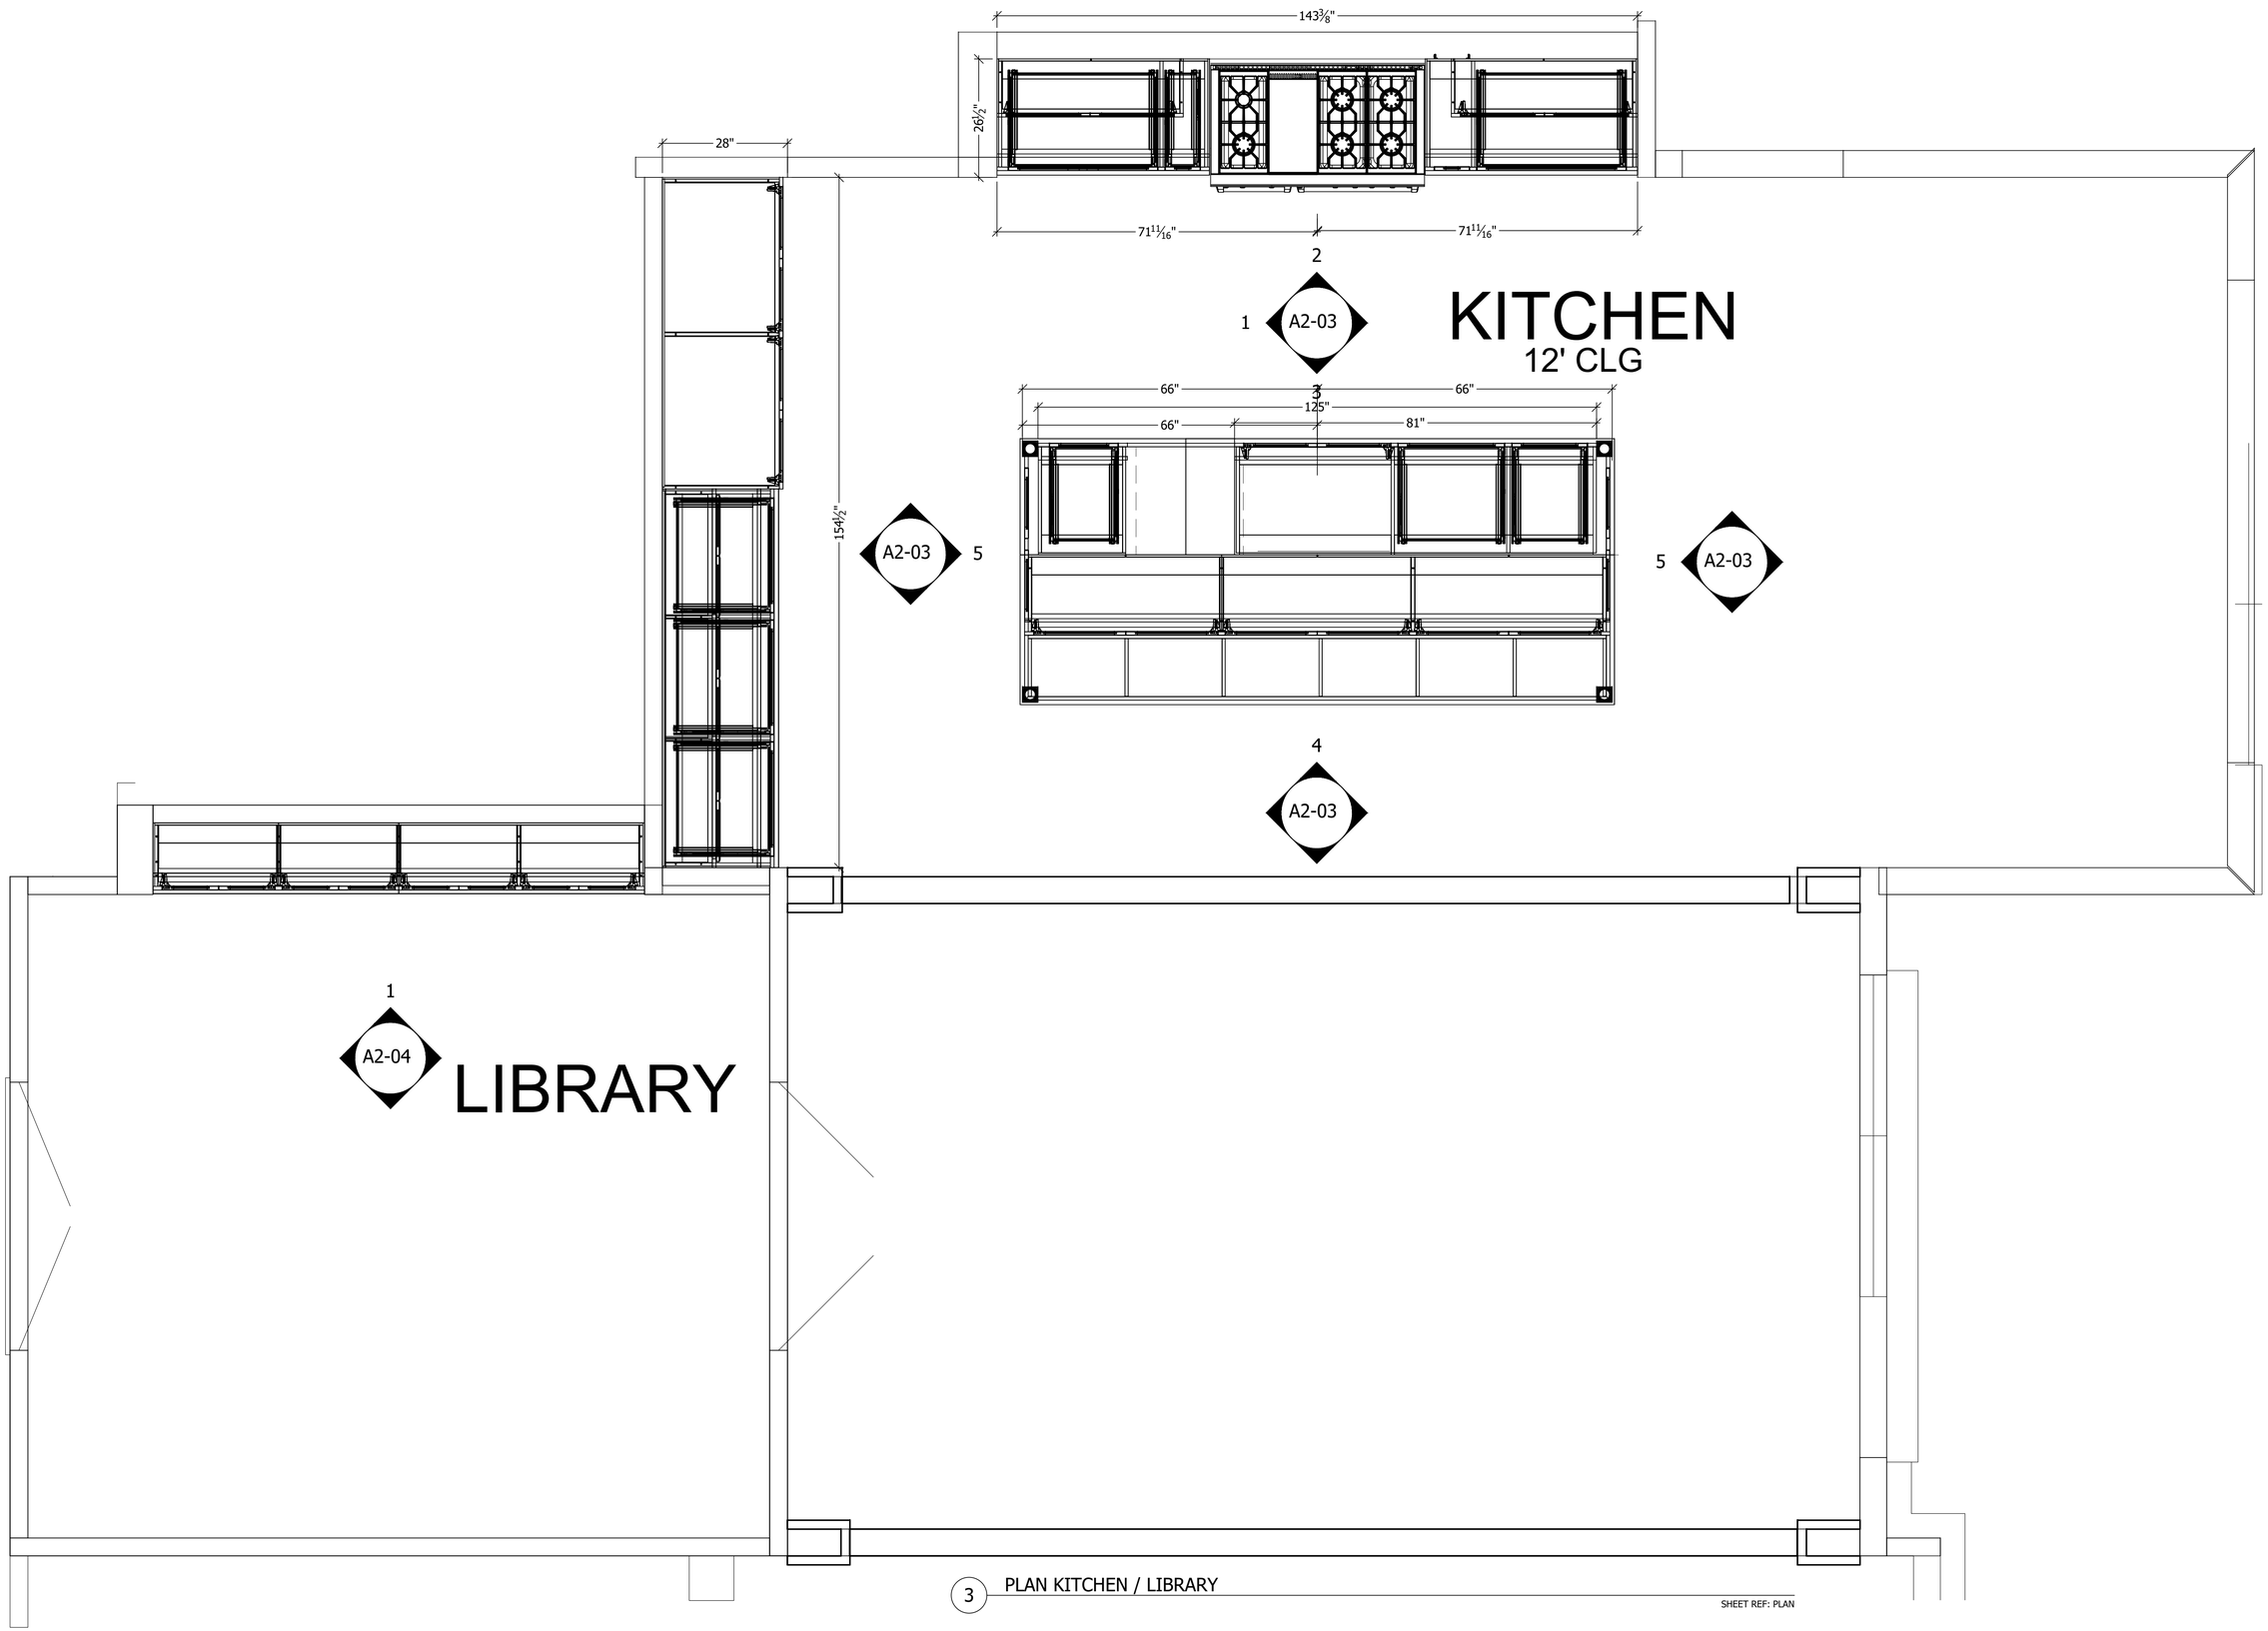

3 PLAN KITCHEN / LIBRARY

SHEET REF: PLAN

CUTTING EDGE CABINET DESIGN

TEXAS A&M UNIVERSITY 1876


TAMU

Project Title: 26-024 Caldwell Residence
Project Number:
Project Address:
Project Phone:
Project Fax:
Project E-Mail:
Contractor:
Sheet Title:

REVISIONS:


No.	Date:	By:	Description:
1			
2			
3			
4			
5			
6			
7			
8			

Scale	3/4" = 1'
Date Issued	10.27.2026
Sheet Number	A1-03

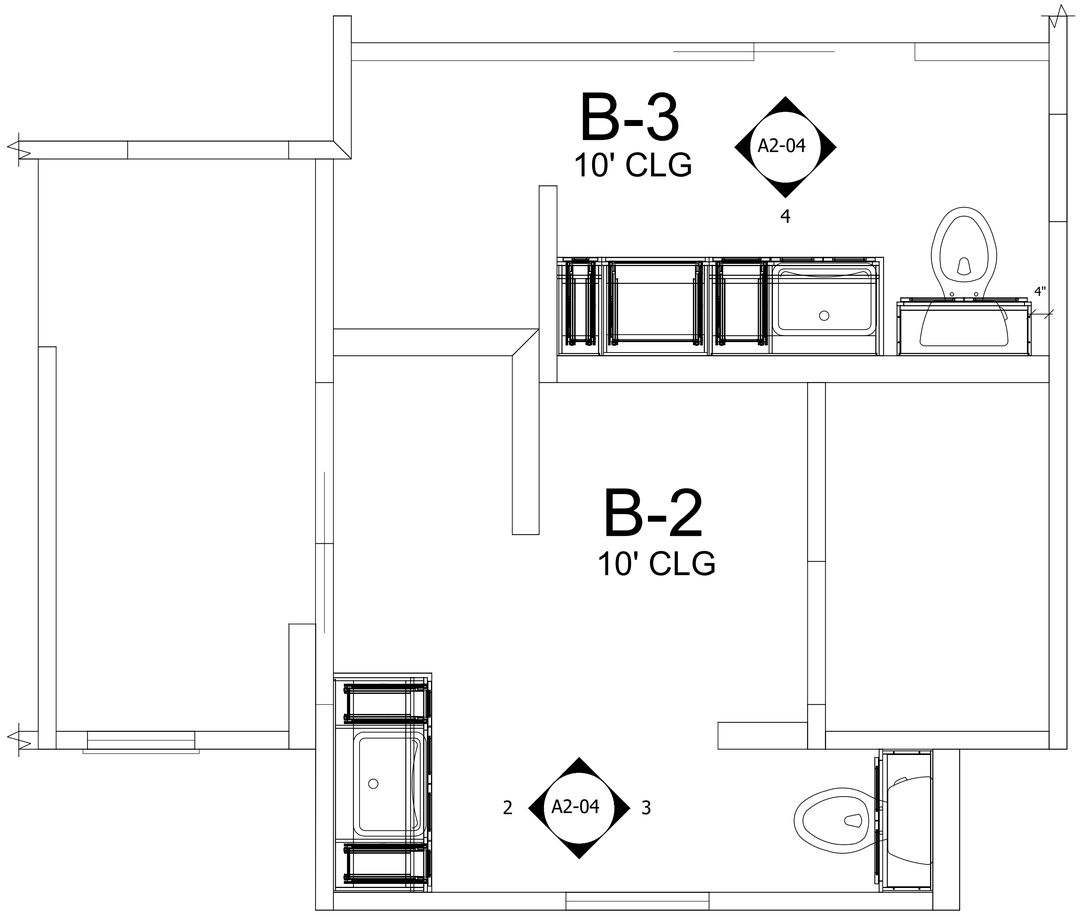


4 PLAN BATH 2 / BATH 3

Sheet Ref: PLAN

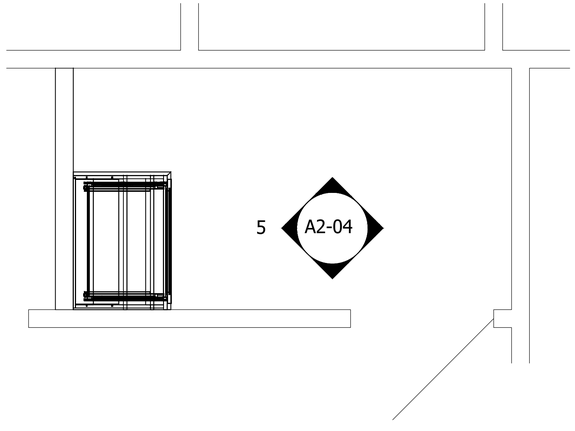

5 PLAN BDR 3 CLOSET

Sheet Ref: PLAN

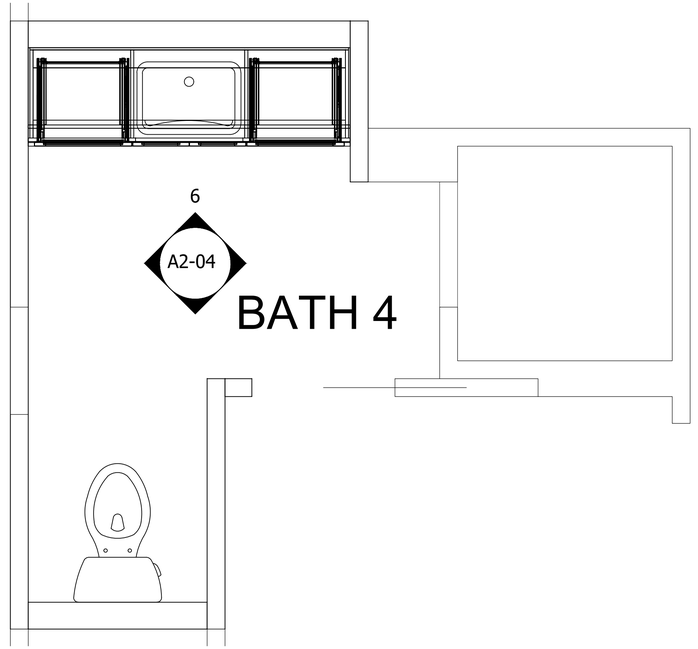

6 PLAN 201 BATH 4

Sheet Ref: PLAN 2


TAMU

Project Title: 26-024 Caldwell Residence
Project Number:
Project Address:
Project Phone:
Project Fax:
Project E-Mail:
Contractor:
Sheet Title:

REVISIONS:


No.	Date:	By:	Description:
1			
2			
3			
4			
5			
6			
7			
8			

Scale	3/4" = 1'
Date Issued	10.27.2026
Sheet Number	A1-04

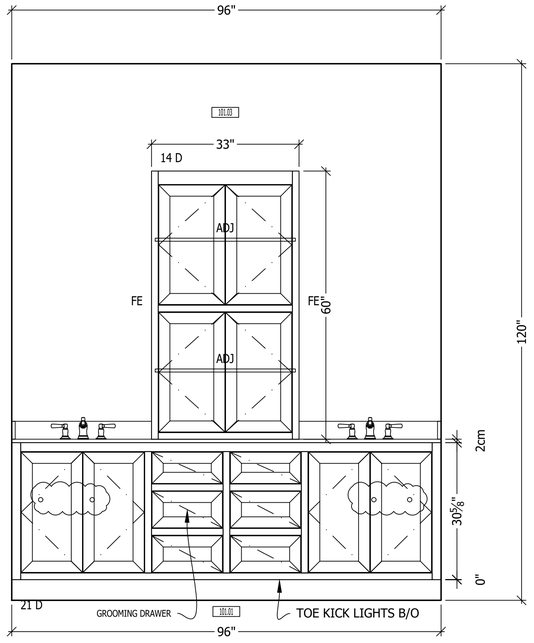


1 ELV MASTER BATH 101

Sheet Ref: A1-01

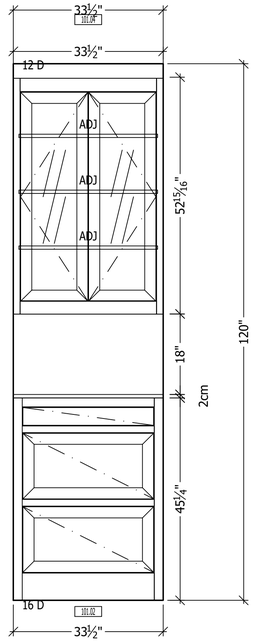


2 ELV MASTER BATH 101

Sheet Ref:A1-01

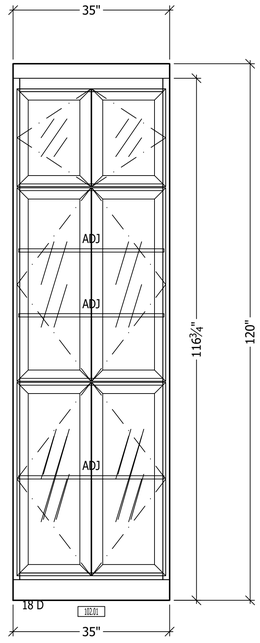


3 ELV MASTER CLOSET 102

Sheet Ref: A1-01

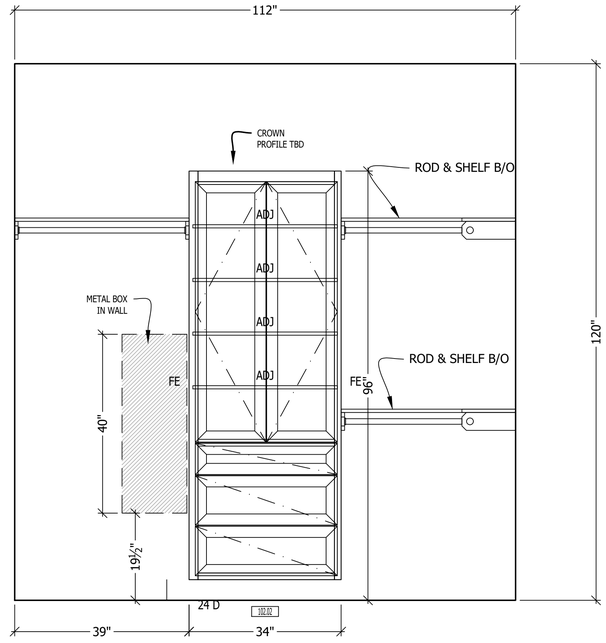


4 ELV MASTER CLOSET 102

Sheet Ref: A1-01

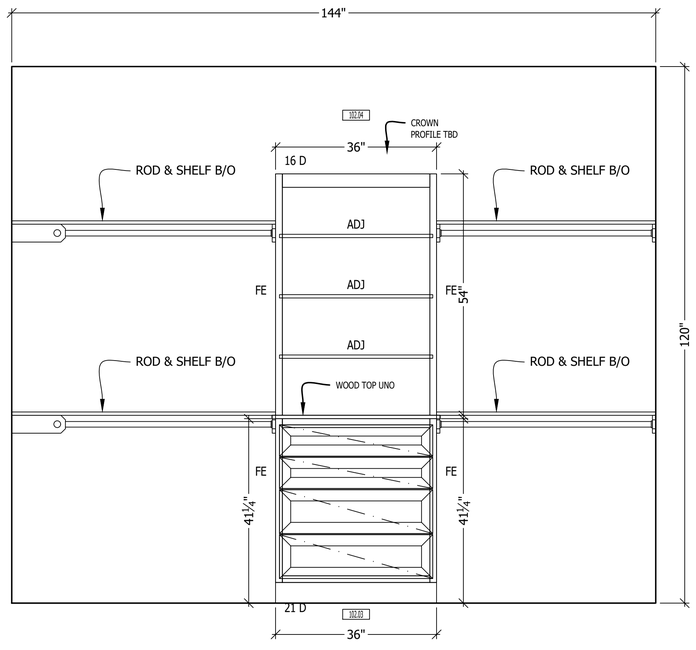


5 ELV MASTER CLOSET 102

Sheet Ref: A1-01

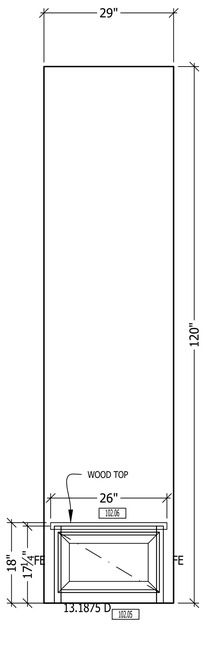


6 ELV MASTER CLOSET 102

Sheet Ref: A1-02

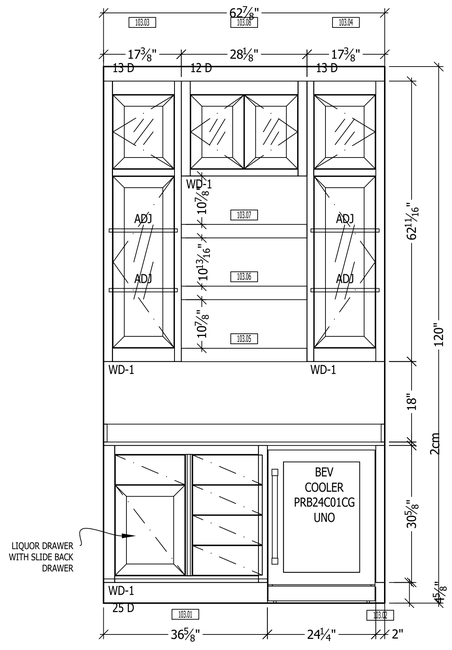

7 ELV COFFEE BAR 103

Sheet Ref: A1-02

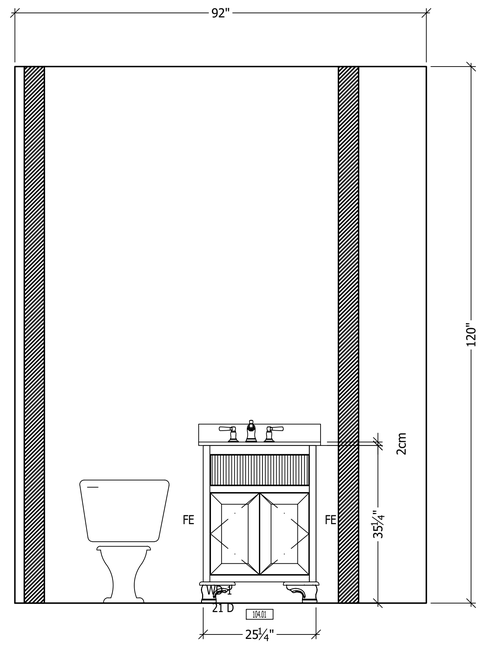

8 ELV HALF BATH 104

Sheet Ref: A1-02

CUTTING EDGE CABINET DESIGN

TEXAS A&M UNIVERSITY 1876

TAMU

Project Title: 26-024 Caldwell Residence

Project Number:

Project Address:

Project Phone:

Project E-Mail:

Contractor:


Sheet Title:

Project Fax:

REVISIONS:


No.	Date:	By:	Description:
1			
2			
3			
4			
5			
6			
7			
8			

Scale	3/4" = 1'
Date Issued	10.27.2026
Sheet Number	A2-01

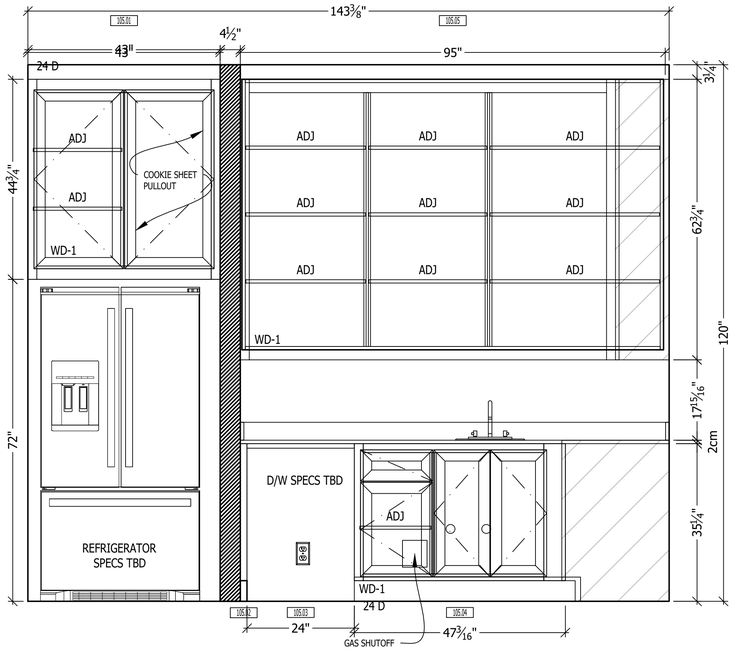


1 ELV SCULLERY 105

Sheet Ref: A1-02

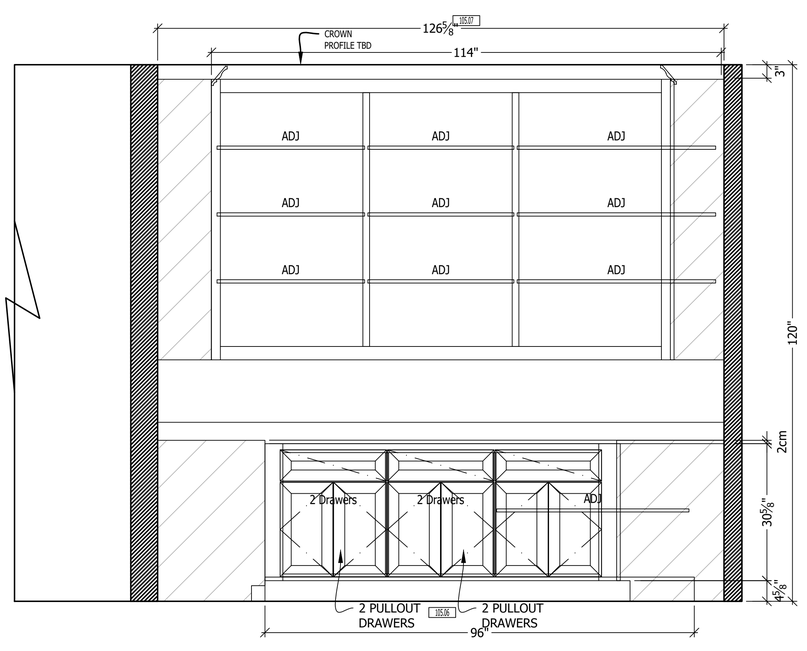


2 ELV SCULLERY 105

Sheet Ref: A1-02

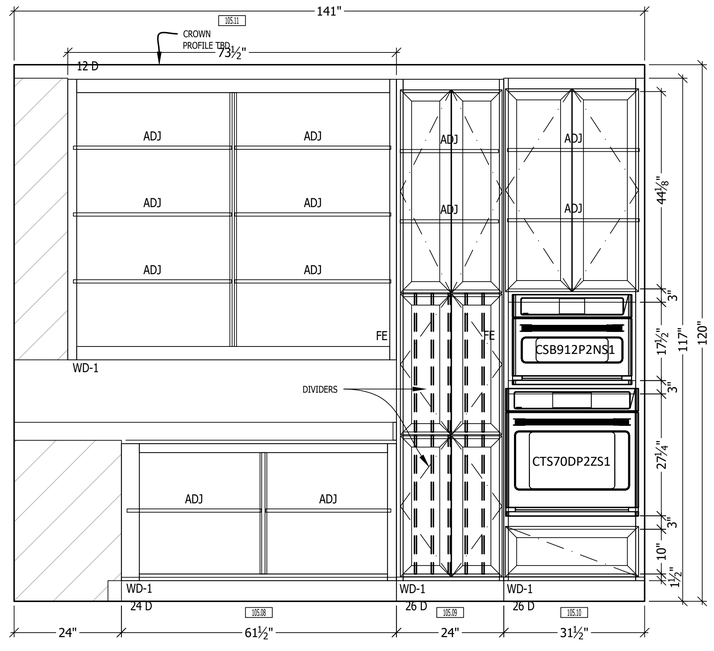


3 ELV SCULLERY 105

Sheet Ref: A1-02

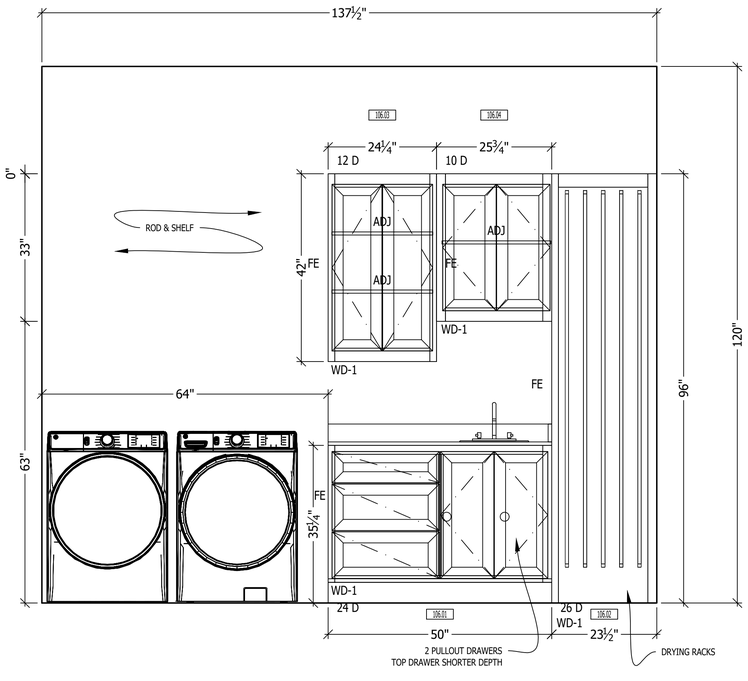


4 ELV UTILITY 106

Sheet Ref: A1-02

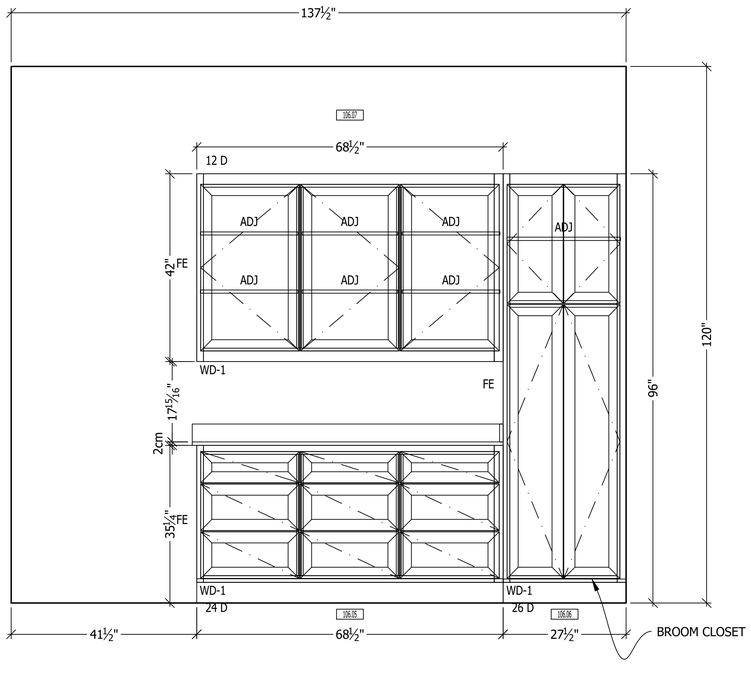

5 ELV UTILITY 106

Sheet Ref:A1-02

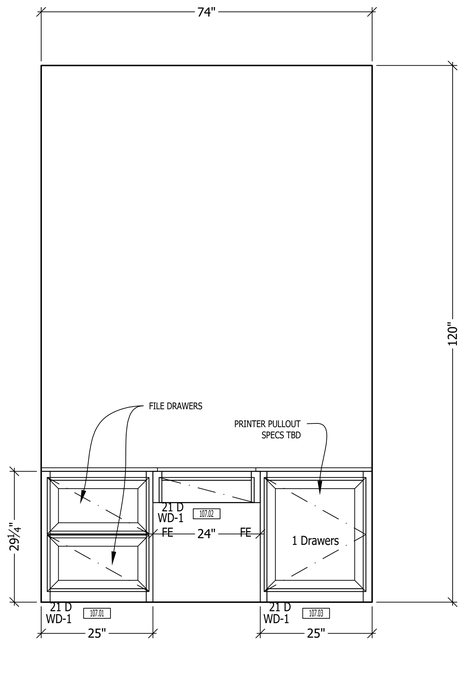

6 ELV HOBBY ALCOVE 107

Sheet Ref:A1-02

CUTTING EDGE CABINET DESIGN

TEXAS A&M UNIVERSITY 1876

TAMU

Project Title: 26-024 Caldwell Residence

Project Number:

Project Address:

Project Phone:

Project E-Mail:

Contractor:


Project Fax:

Sheet Title:

REVISIONS:


No.	Date:	By:	Description:
1			
2			
3			
4			
5			
6			
7			
8			

Scale	3/4" = 1'
Date Issued	10.27.2026
Sheet Number	A2-02

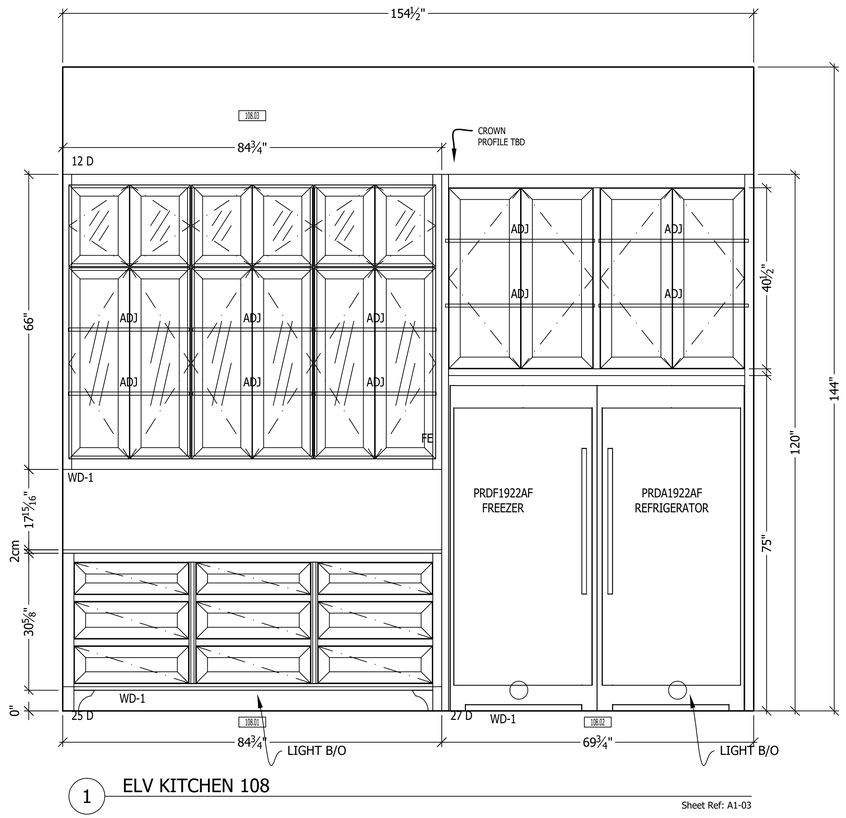


1 ELV KITCHEN 108

Sheet Ref: A1-03

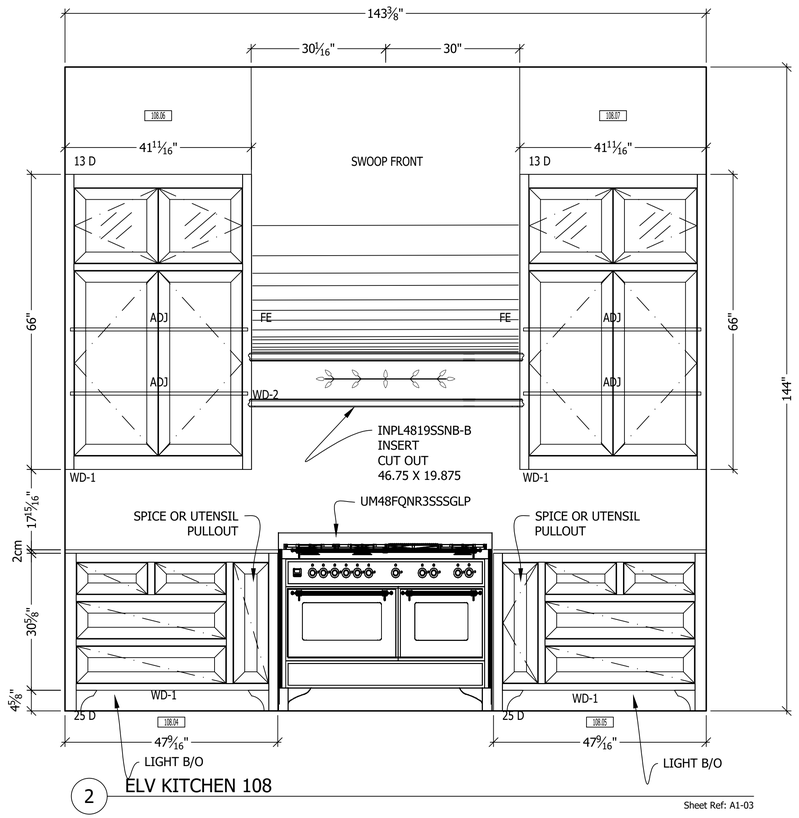


2 ELV KITCHEN 108

Sheet Ref: A1-03

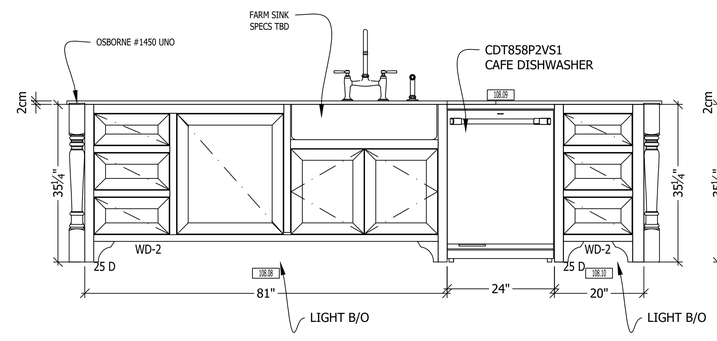


3 ELV KITCHEN 108

Sheet Ref: A1-03

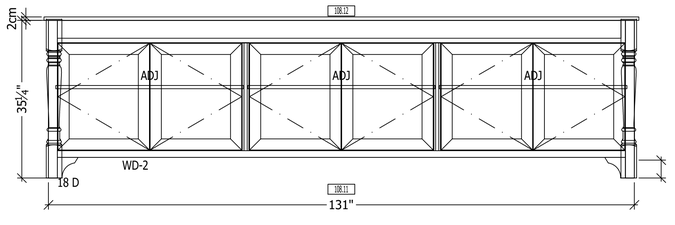

4 ELV KITCHEN 108

Sheet Ref: A1-03

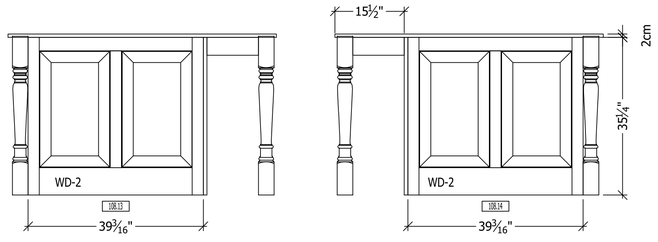

5 ELV KITCHEN 108

Sheet Ref:A1-03

TAMU

Project Title: 26-024 Caldwell Residence

Project Number:

Project Address:

Project Phone: Project Fax:

Project E-Mail:


Contractor:

Sheet Title:

REVISIONS:


No.	Date:	By:	Description:
1			
2			
3			
4			
5			
6			
7			
8			

Scale	3/4" = 1'
Date Issued	10.27.2026
Sheet Number	A2-03

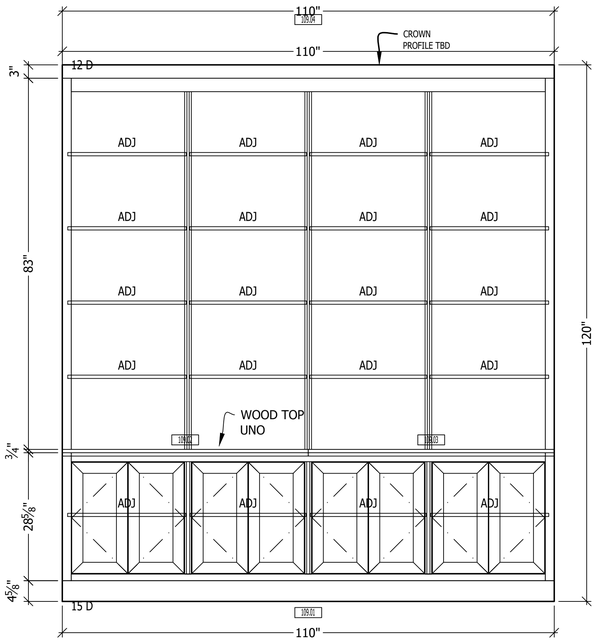


1 ELV LIBRARY 109

Sheet Ref: A1-03

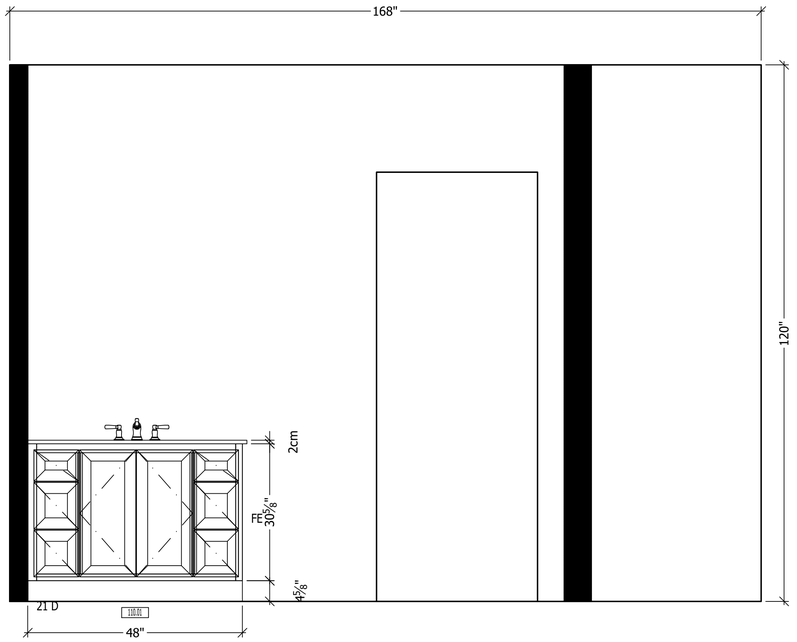


2 ELV BATH 2 110

Sheet Ref: A1-04

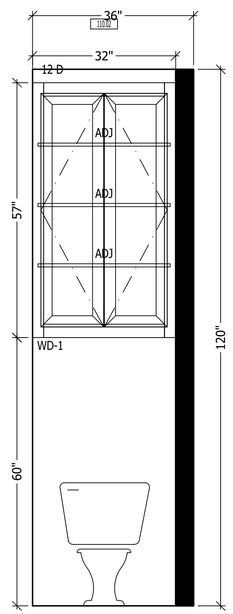


3 ELV BATH 2 110

Sheet Ref: A1-04

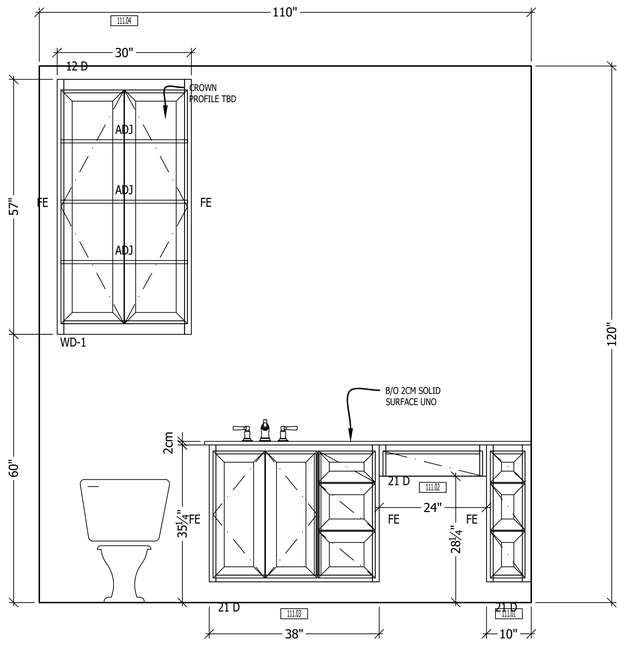


4 ELV BATH 3 111

Sheet Ref: A1-04

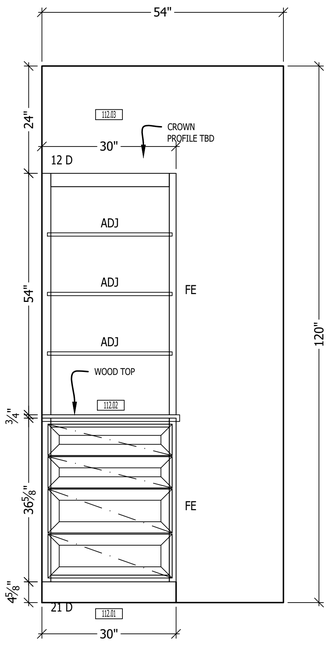

5 ELV BDR 3 CLOSET 112

Sheet Ref: A1-04

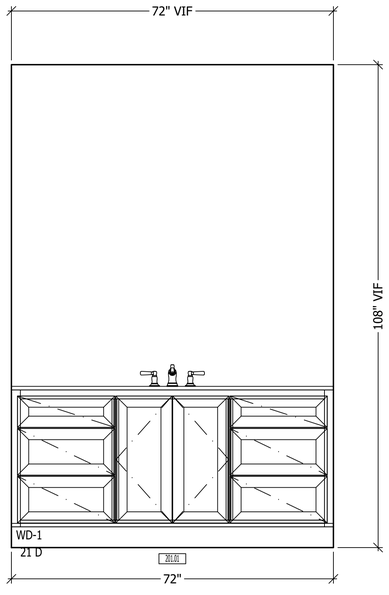

6 ELV BATH 4 201

Sheet Ref: A1-04

TAMU

Project Title: 26-024 Caldwell Residence

Project Number:

Project Address:

Project Phone:

Project E-Mail:

Contractor:

Project Fax:

Sheet Title:

REVISIONS:

No.	Date:	By:	Description:
1			
2			
3			
4			
5			
6			
7			
8			

Scale	3/4" = 1'
Date Issued	10.27.2026
Sheet Number	A2-04